

## On-site Wastewater Treatment System Record Drawing

Property Address 1234 Joe Smith Street, Franktown CO

Permit # ON00---


System Completion Date 12/27/16

Installer Name Joe Smith

Installer License # CI---

Installer Address 1234 Joe Smith Street, Franktown CO

Installer Phone (303) 123-4567

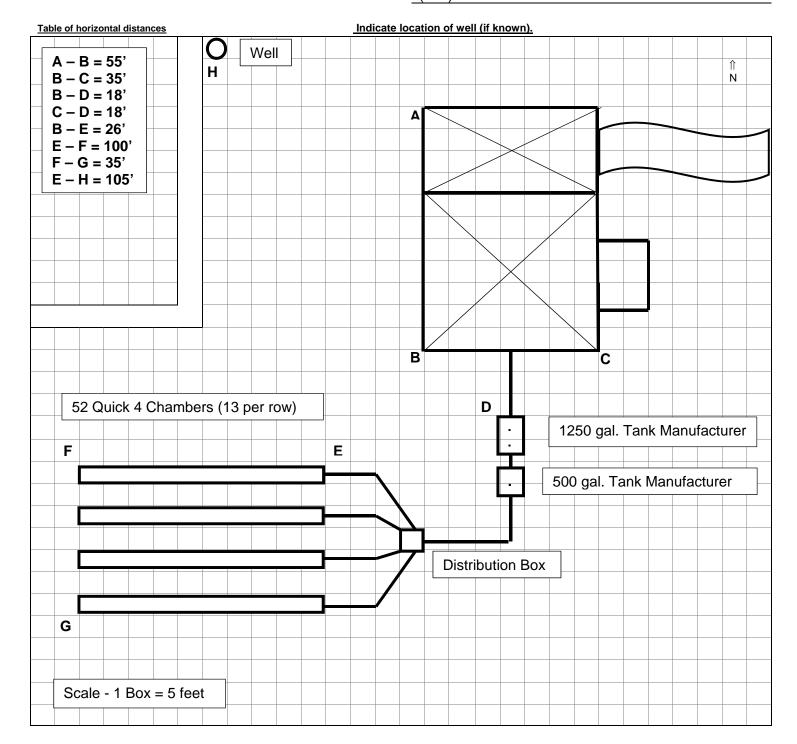

S-481 12/22